




2 Main Level
2,192 Sq Ft

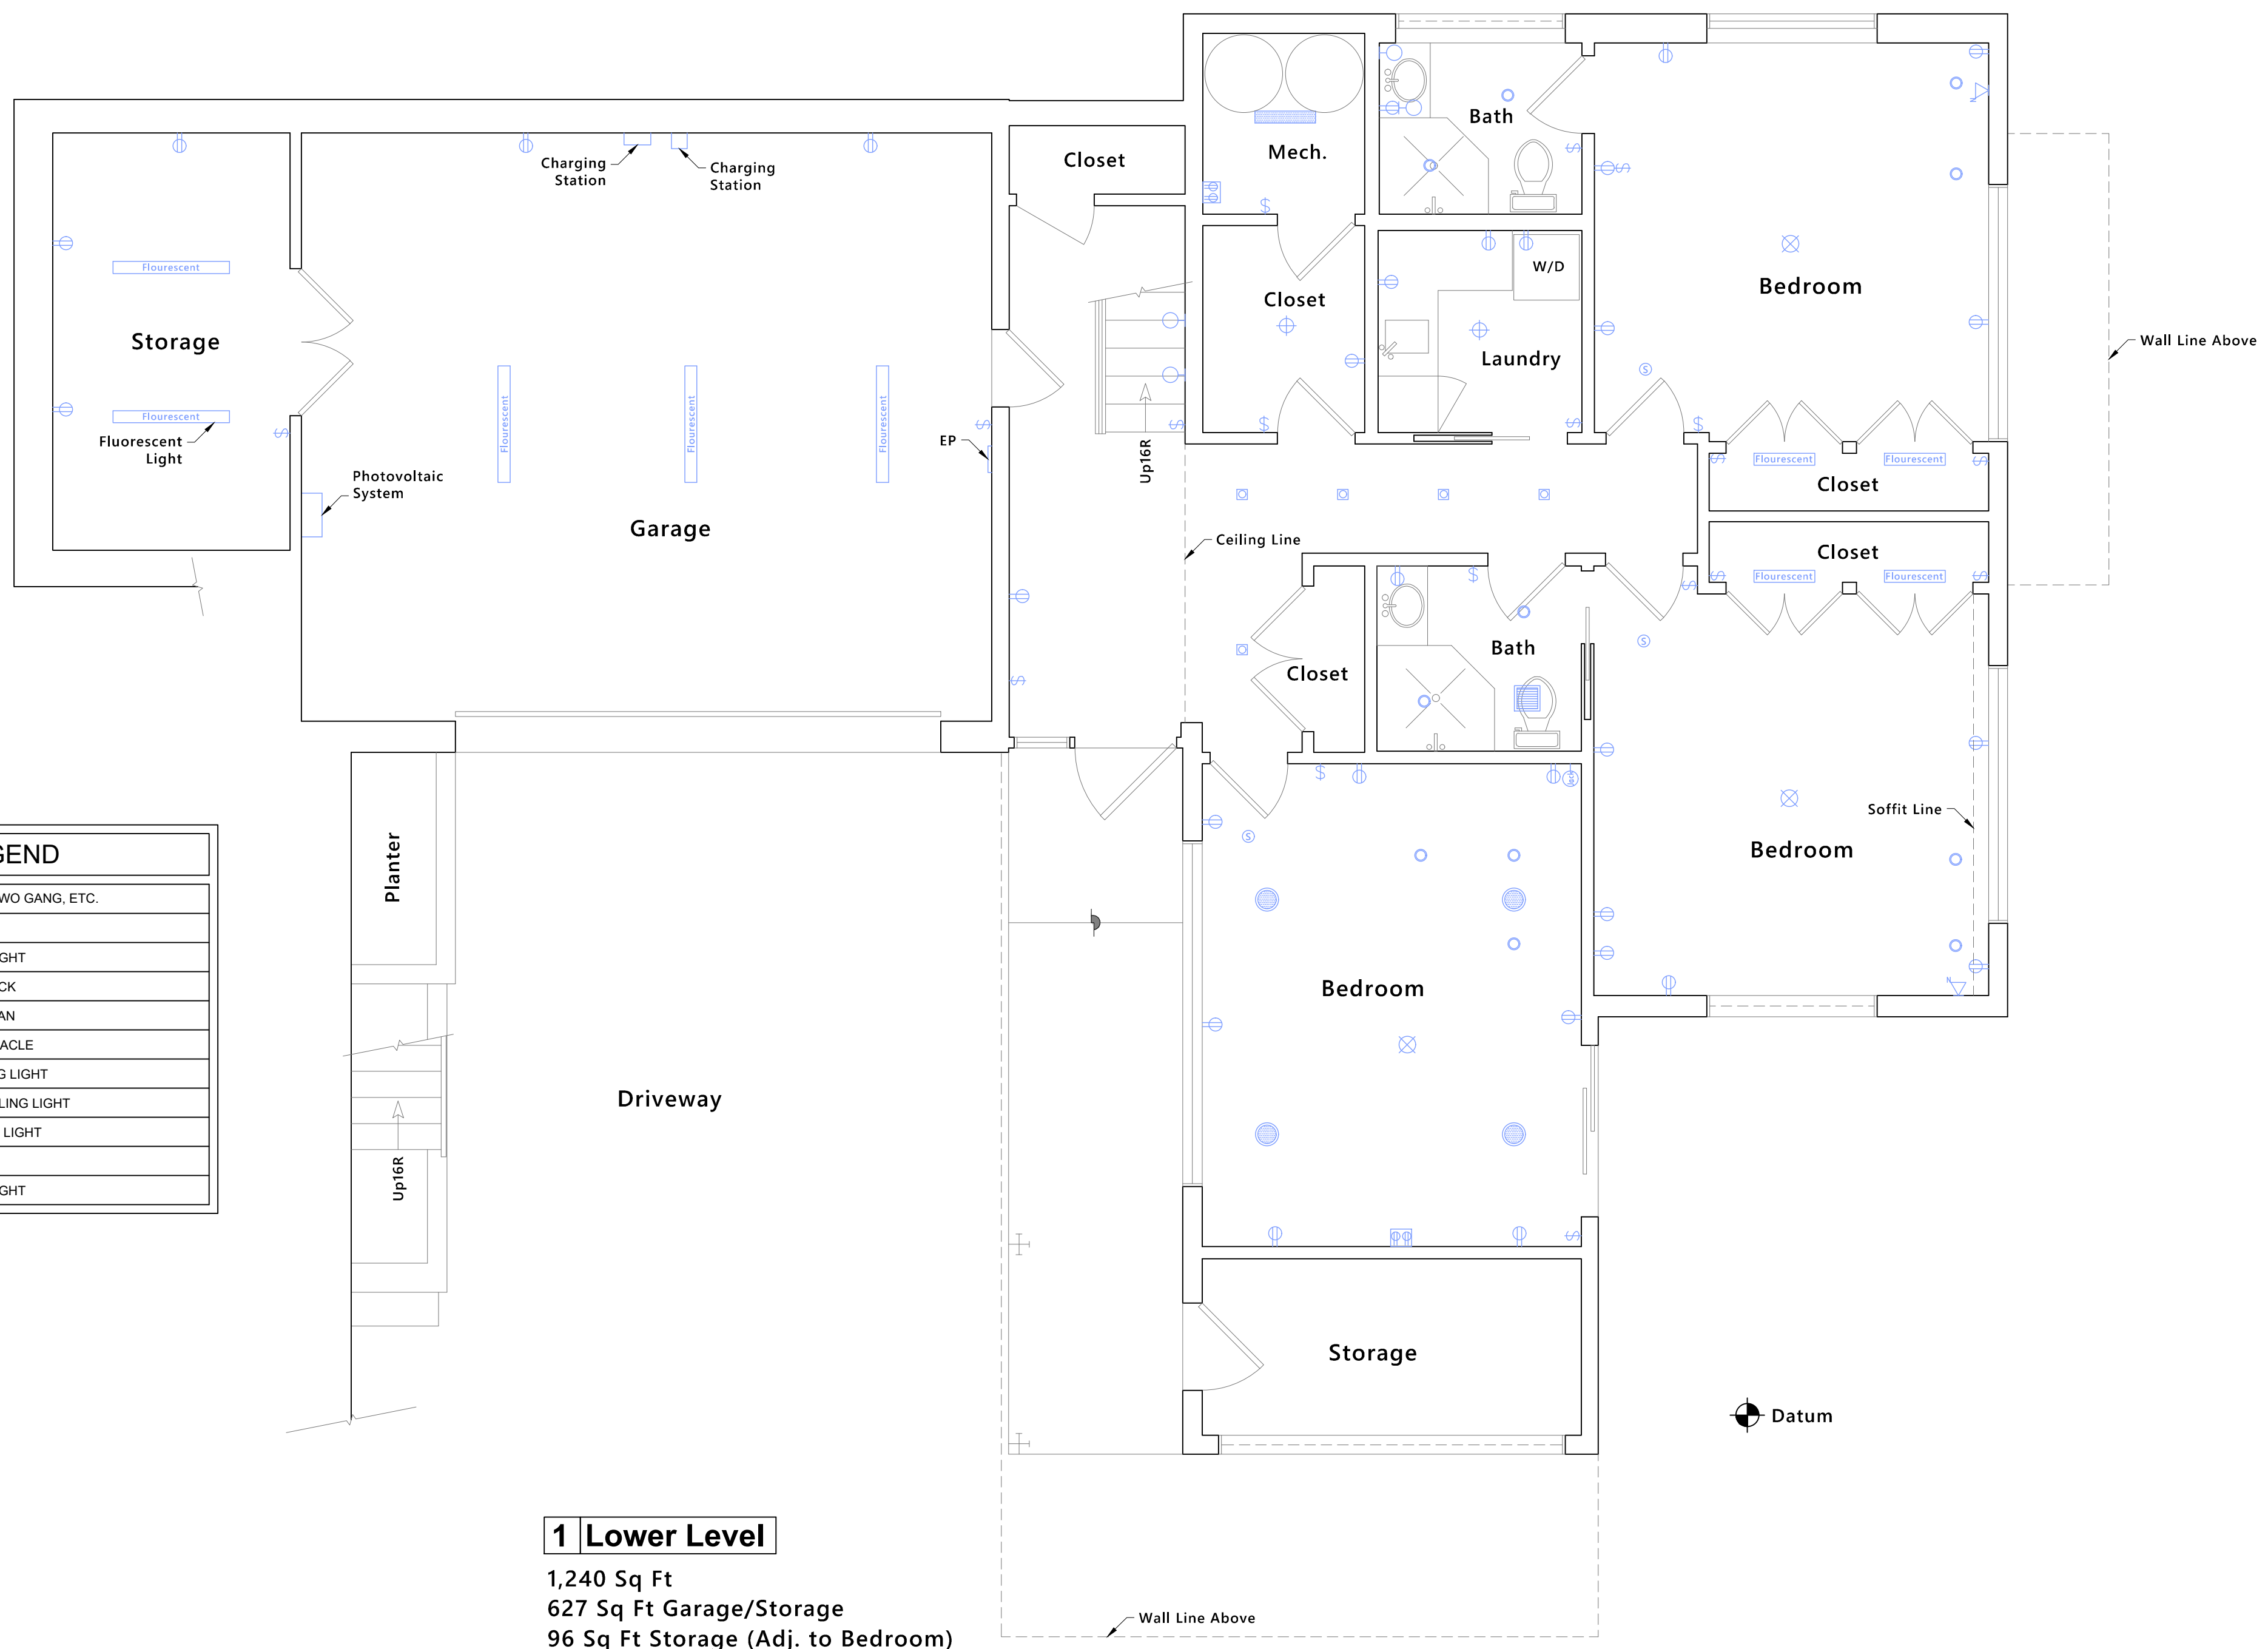

LEGEND	
	SWITCH, = TWO GANG, ETC.
	RECEPTACLE
	RECESSED LIGHT
	NETWORK JACK
	BATH VENT/FAN
	220V RECEPTACLE
	FIXED CEILING LIGHT
	HANGING CEILING LIGHT
	WALL MOUNT LIGHT
	SPEAKER
	RECESSED LIGHT

1 Lower Level
1,240 Sq Ft
627 Sq Ft Garage/Storage
96 Sq Ft Storage (Adj. to Bedroom)