


1 | SOUTHWEST ELEVATION

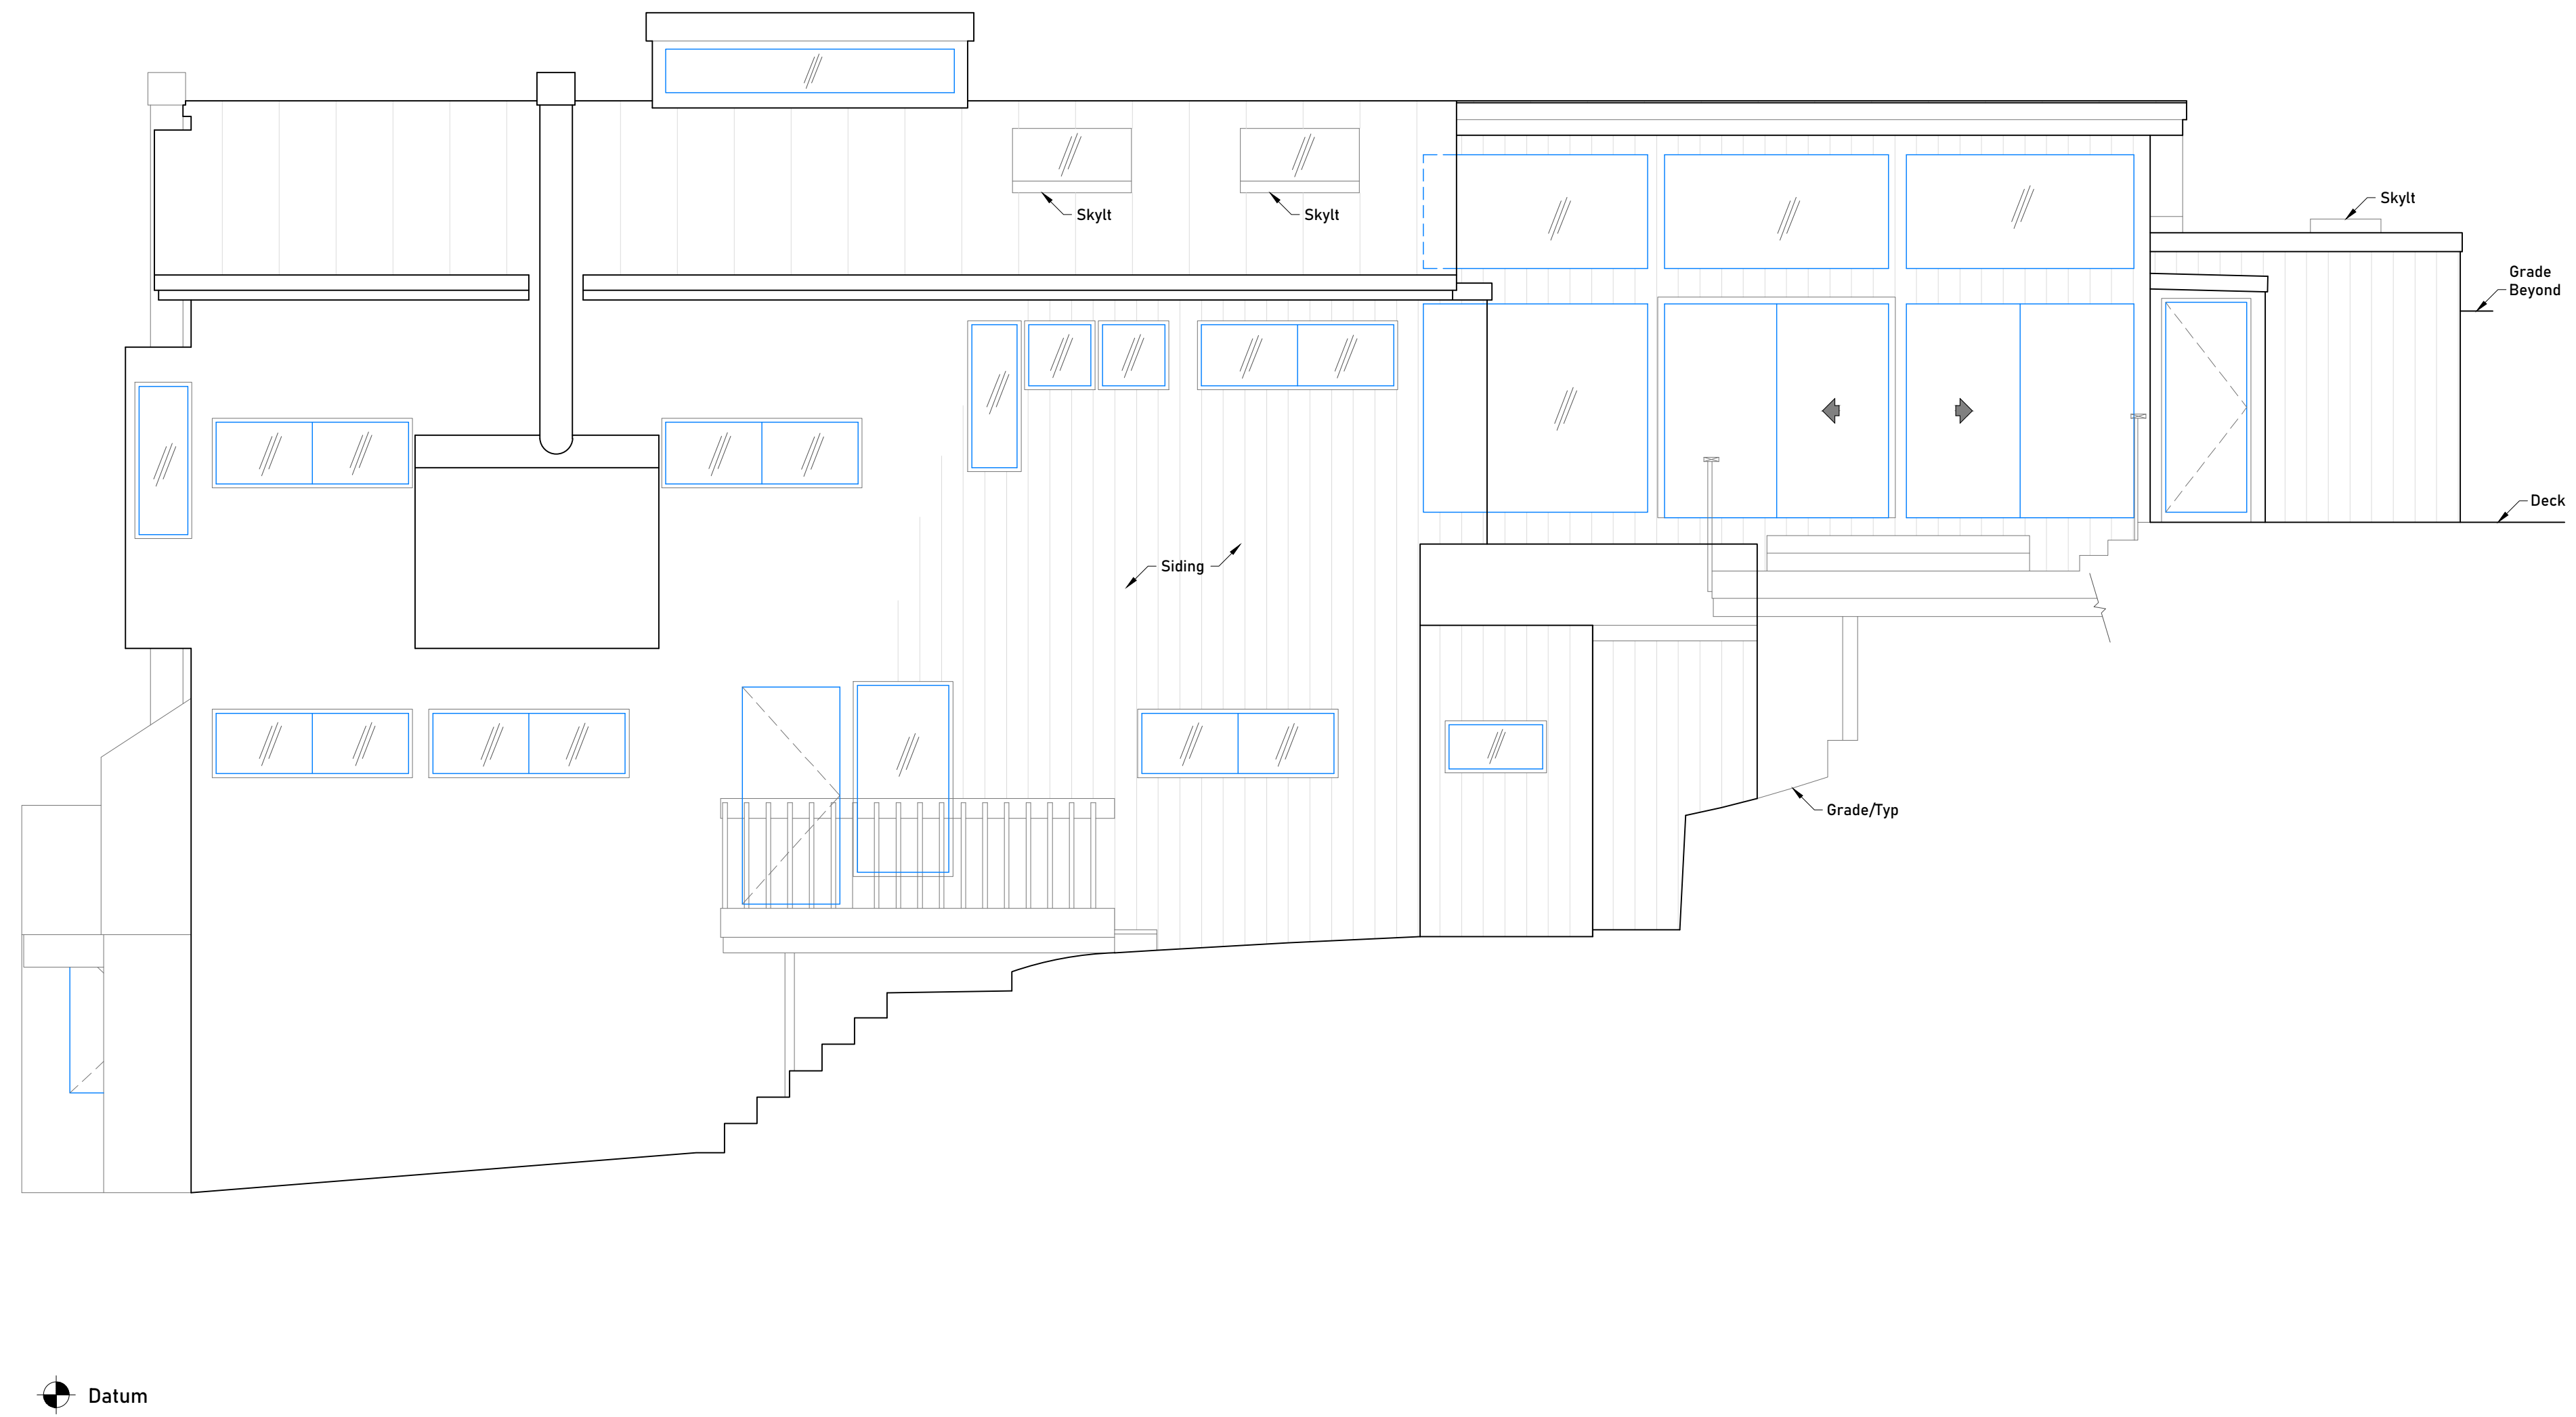

2 | NORTHWEST ELEVATION

100 SAMPLE AVENUE, TIBURON, CA 94920

EXISTING EXTERIOR ELEVATIONS

OCTOBER 07, 2022

SCALE: 1/4" = 1'-0"

OPEN HOUSE DRAFTING

CHRIS DANIGELIS / CHRIS@OPENHOUSEDRAFTING.COM
415.999.9599

A2.2