




1 LONGITUDINAL SECTION

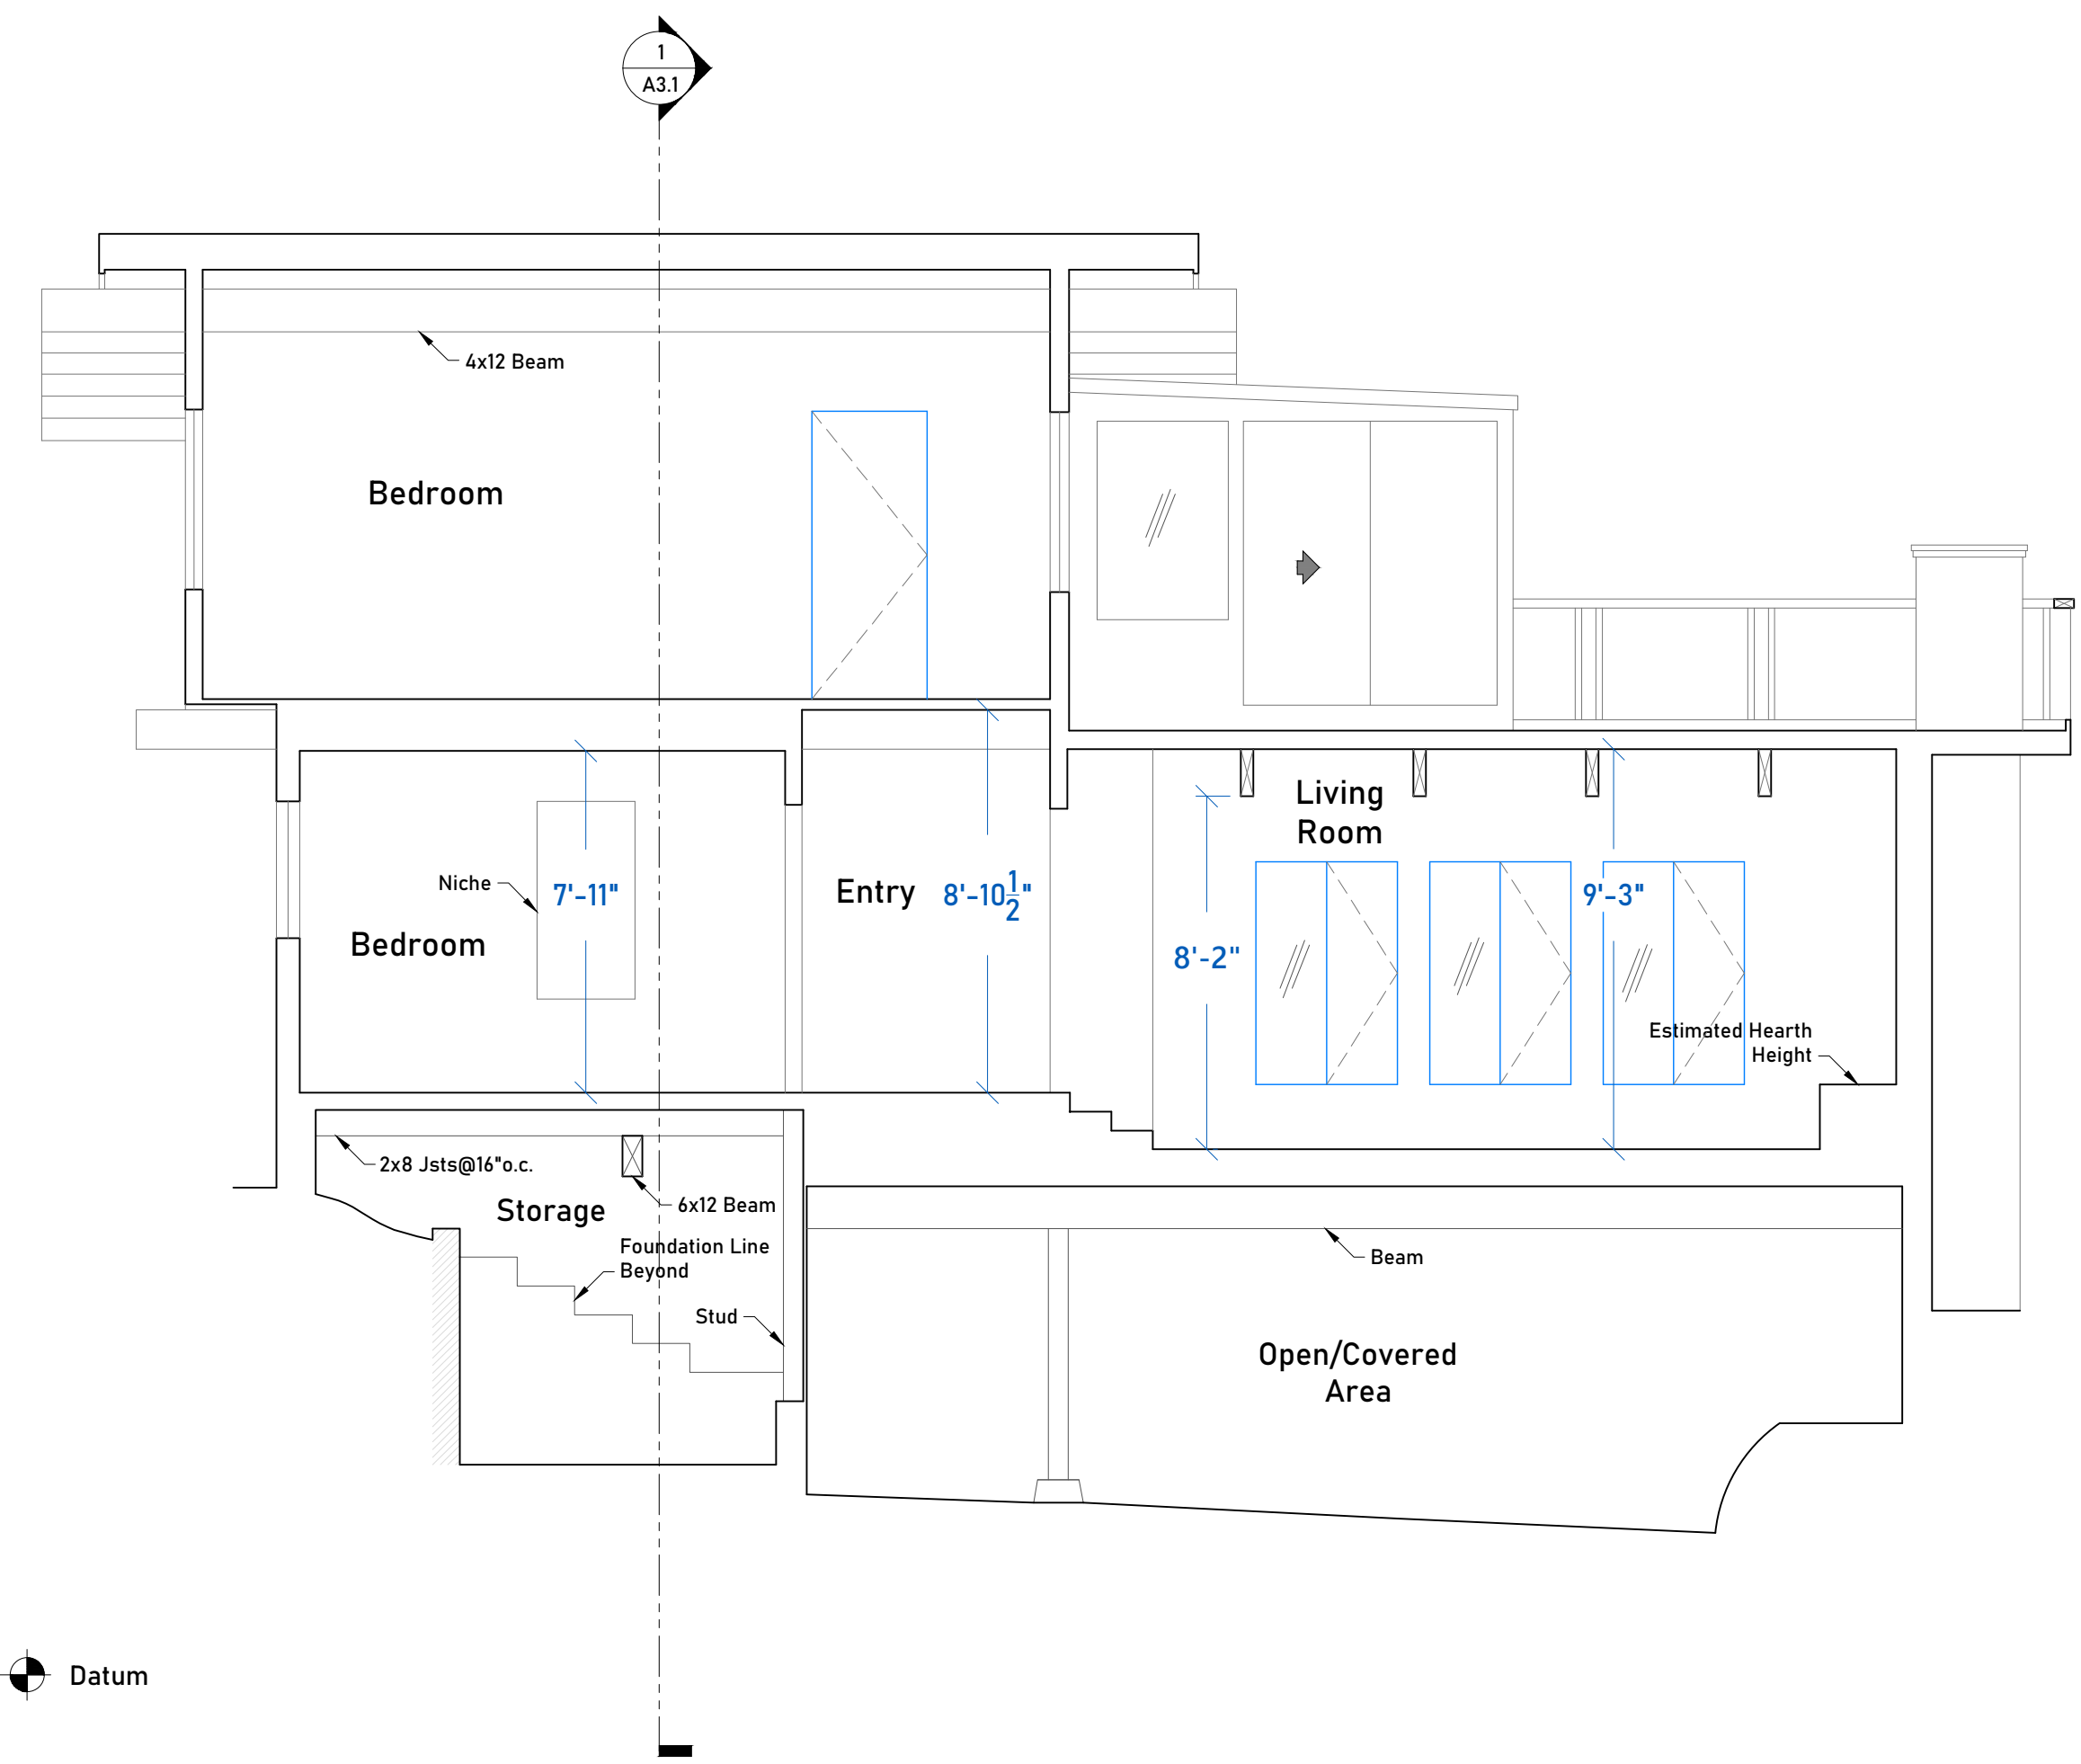

2 CROSS SECTION